



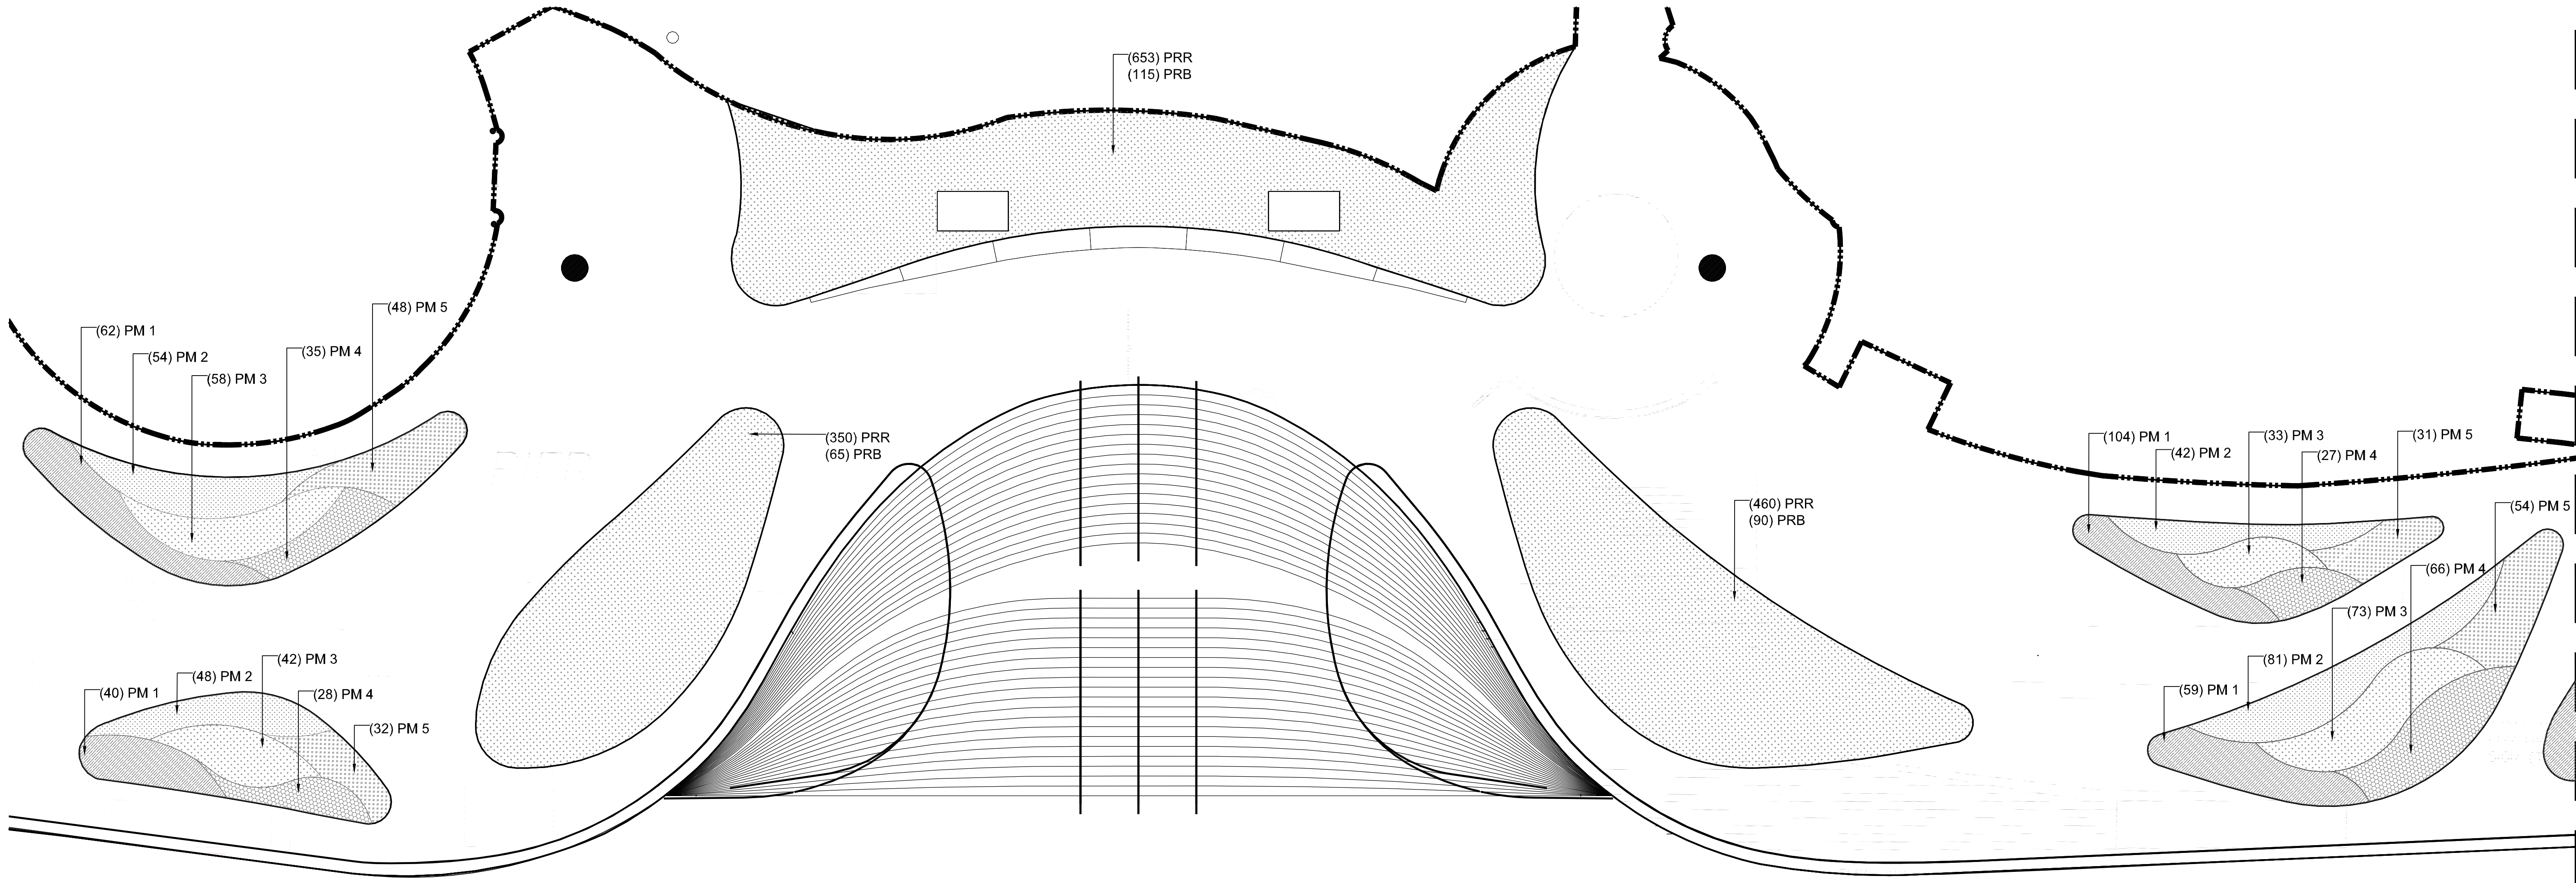




01 TEMPORARY PIER PARK PLANTING PLAN

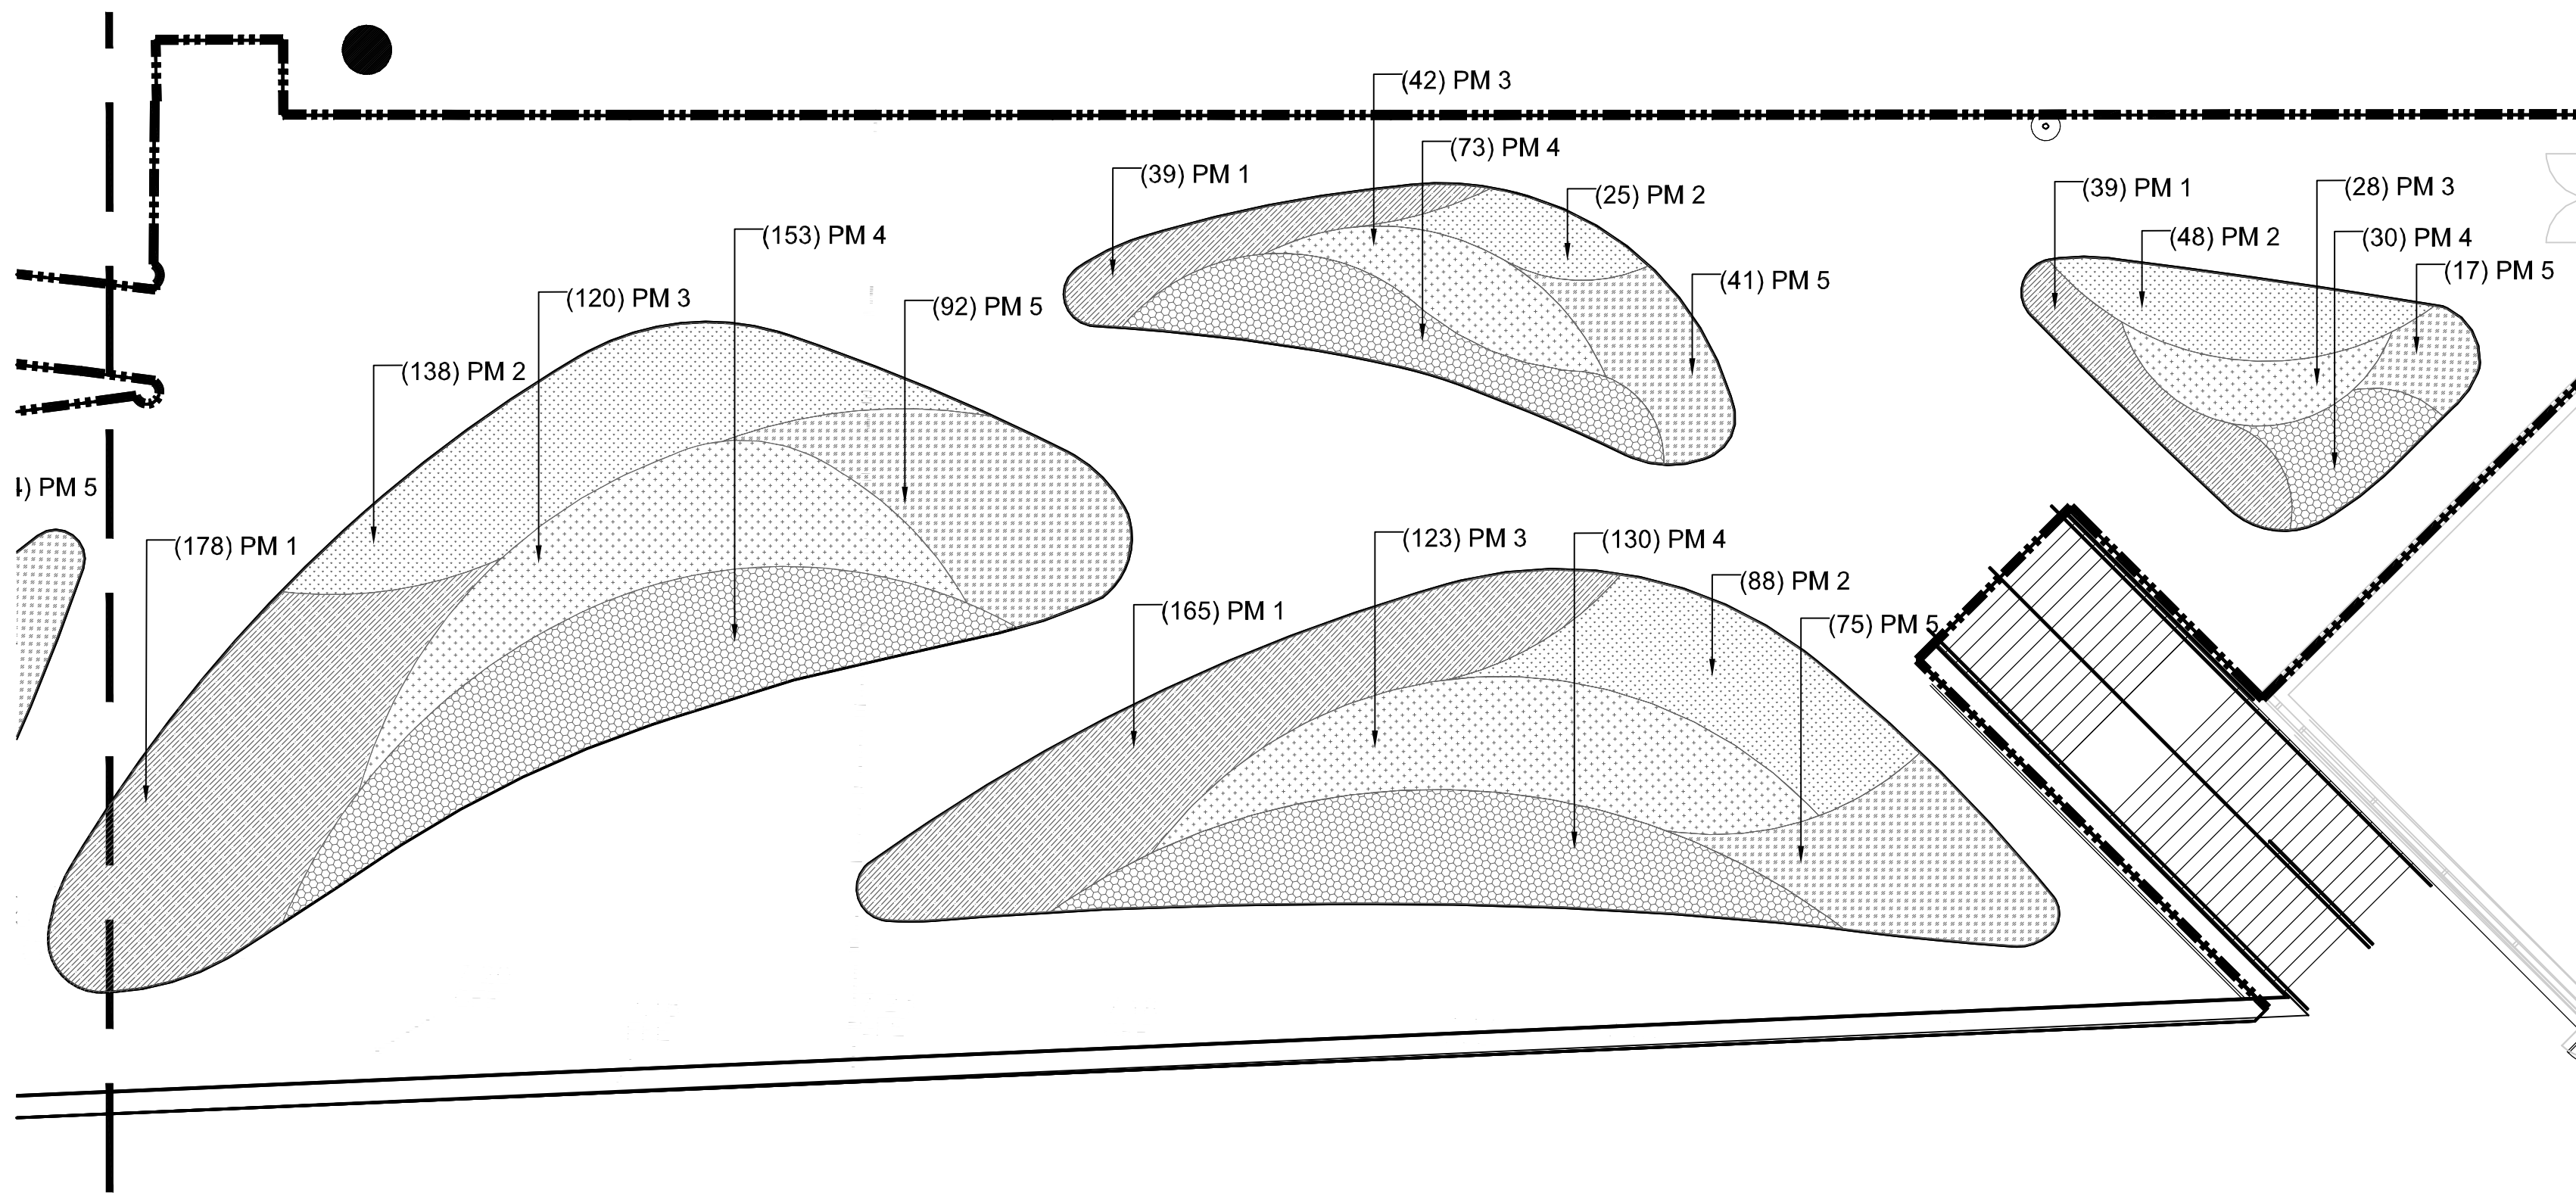

02 TEMPORARY PIER PARK PLANTING PLAN

PLANT SCHEDULE					
SYM	QTY	BOTANICAL NAME	COMMON NAME	SIZE / SPACING	NOTES
PERENNIALS					
PM 1	670	Perennial Mix 1 TBD	TBD	1 gal., 18" O.C.	well developed roots
PM 2	535	Perennial Mix 2 TBD	TBD	1 gal., 18" O.C.	well developed roots
PM 3	525	Perennial Mix 3 TBD	TBD	1 gal., 18" O.C.	well developed roots
PM 4	550	Perennial Mix 4 TBD	TBD	1 gal., 18" O.C.	well developed roots
PM 5	400	Perennial Mix 5 TBD	TBD	1 gal., 18" O.C.	well developed roots
GRASSES & SEDGES					
PRR	1465	Panicum virgatum 'Ruby Ribbons'	Switchgrass	1 gal., 18" O.C.	fully developed roots
PRB	280	Panicum virgatum 'Rotstrahlbusch'	Red Switchgrass	1 gal., 18" O.C.	well developed roots
BULBS					
AB	xx	Anemone blanda 'Blue Star'	Blue Star Anemore	bulb	well developed bulbs
IV	xx	Iris versicolor	Blue Flag Iris	bulb	well developed bulbs
SP	xx	Scilla pratensis	Mweadow Squill	bulb	well developed bulbs

03 PLANT SCHEDULE

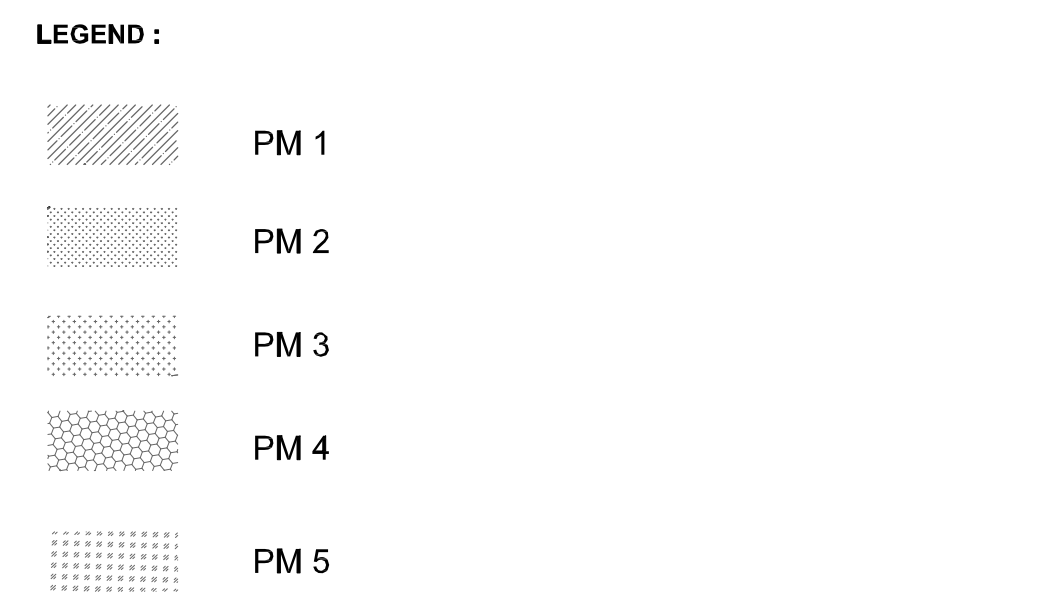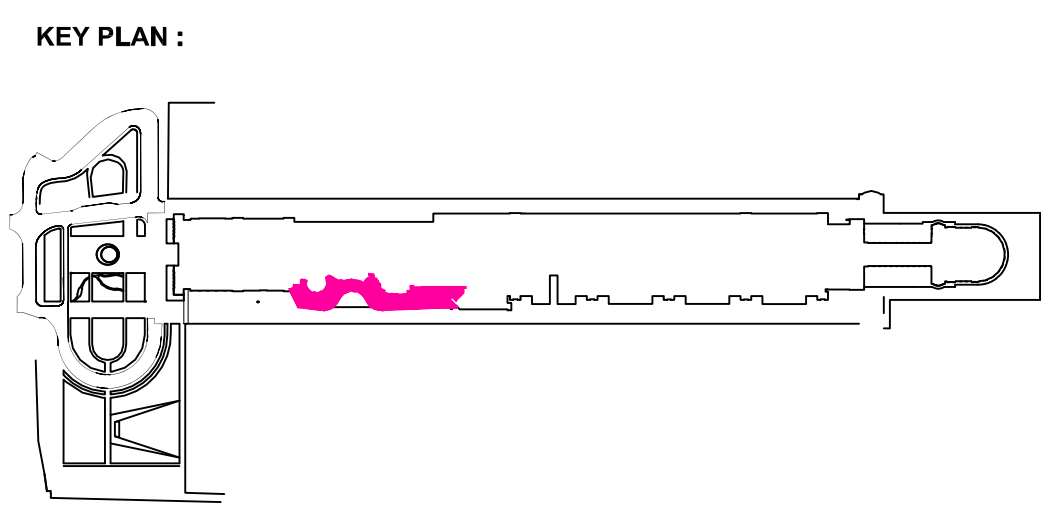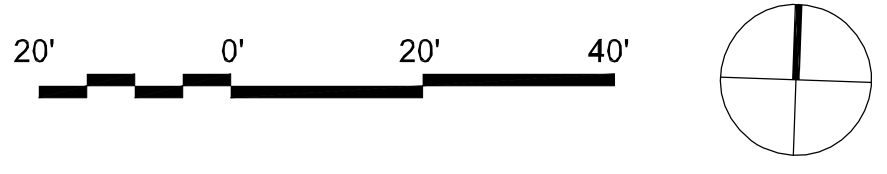

LANDSCAPE ARCHITECT :

James Corner Field Operations
475 Tenth Ave, 10F New York, NY 10018

CONSULTANT TEAM :

nArchitects
68 Jay Street, #517, Brooklyn, NY 11201

Buro Happold
601 West Adams Street, Suite 800, Chicago, IL 60607

Primer
100 South Wacker Drive, Suite 700, Chicago, Illinois 60606

L'Observatoire International
120 Walker Street 7 Floor East, New York, New York 10013

Terry Guen Design Associates
714 South Dearborn Street, # 5, Chicago, Illinois 60605

Billings Jackson
100 Broadway, New York, NY 10005

Pentagram
204 Fifth Avenue, New York NY 10010

Jeffrey L. Bruce & Company, LLC
1907 Swift Street, Suite 204, North Kansas City, Missouri 64116

Collins Engineers, Inc.
123 North Wacker Drive, Suite 800, Chicago, Illinois 60606

Cline & Associates, Inc.
2413 W. Algoshin Road 431, Algonquin, Illinois 60102

Fluidity Design Consultants
1680 Vine Street, Floor 7, Los Angeles 90028

Environmental Systems Design
175 West Jackson Boulevard, Suite 1400, Chicago, Illinois 60604

CLIENT :

Navy Pier, Inc.
600 East Grand Avenue, Chicago, IL 60611

PROJECT NAME

CHICAGO NAVY PIER 1C

DESCRIPTION **PERMIT SET**


DRAWN **KK** CHECKED **SWA**

DATE **06.28.2013** SCALE **AS NOTED**

DRAWING TITLE **PIER PARK PLANTING PLAN & SCHEDULE**

DRAWING NO. **L-231**

All Rights Reserved
These drawing, concepts, designs and ideas are the property of James Corner Field Operations. They may not be copied, reproduced, disclosed to others or used in connection with any work other than the specified project for which they were prepared, in whole or in part, without the prior written authorization of James Corner Field Operations.

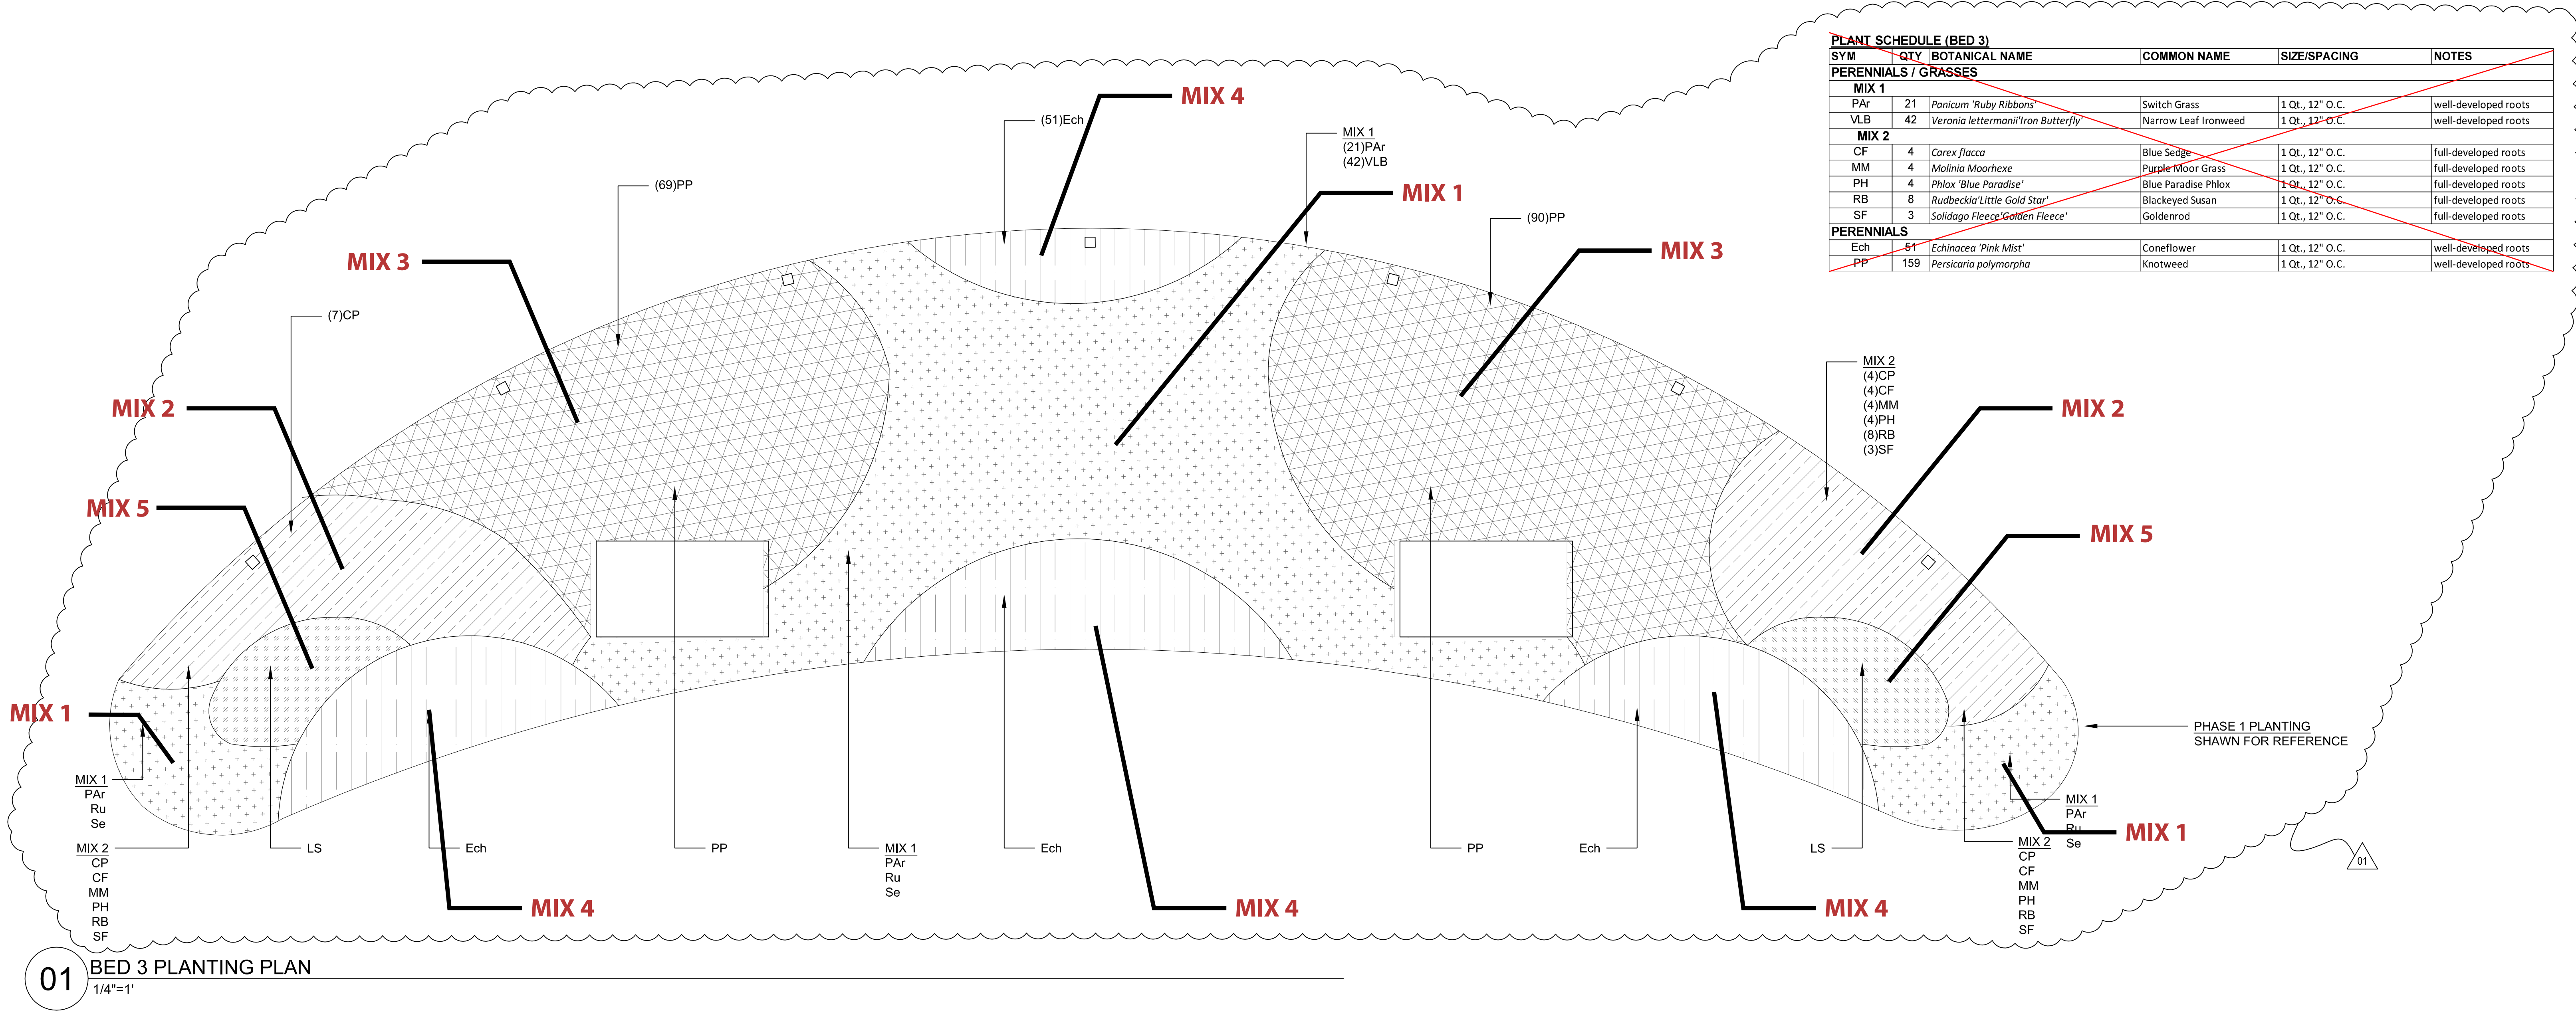

CONCEPT PLANT SCHEDULE


M-MIX 1	563 sf
Calamintha nepeta ssp. nepeta / Lesser Calamint	176
Panicum amarum Rotsrahlbusch / Red Switch Grass	234
Vernonia lettermannii 'Iron Butterfly' / Iron Butterfly Ironweed	176
M-MIX 2	247 sf
Allium x 'Summer Beauty' / Summer Beauty Allium	39
Carex flacca / Blue Sedge	39
Carex pensylvanica / Pennsylvania Sedge	39
Molinia caerulea 'Moorhexe' / Moor Grass	39
Phlox paniculata 'Blue Paradise' / Garden Phlox	39
Rudbeckia fulgida sullivantii 'Little Goldstar' / Coneflower	39
Solidago sphacelata 'Golden Fleece' / Autumn Goldenrod	26
M-MIX 3	622 sf
Nepeta x faassenii 'Walkers Low' / Walkers Low Catmint	194
Persicaria polymorpha / White Fleece Flower	259
Sporobolus heterolepis / Prairie Dropseed	194
M-MIX 4	297 sf
Echinacea x 'Pixie Meadowbrite' / Pixie Meadowbrite Purple Coneflower	186
Sesleria autumnalis / Autumn Moor Grass	124
M-MIX 5	81 sf
Liatris spicata 'Alba' / Spike Blazing-star	51
Sporobolus heterolepis / Prairie Dropseed	34

SK-M-06_L-M-402

PROJECT M - BED 3
PLANTING MARKUP


SEE UPDATED SPECIES AND QUANTITIES IN RED

PLANT SCHEDULE (BED 3)				
SYM	QTY	BOTANICAL NAME	COMMON NAME	SIZE/SPACING
PERENNIALS / GRASSES				
MIX 1				
PAR	21	<i>Panicum 'Ruby Ribbons'</i>	Switch Grass	1 Qt., 12" O.C.
VLB	42	<i>Veronia lettermanii</i> 'Iron Butterfly'	Narrow Leaf Ironweed	1 Qt., 12" O.C.
MIX 2				
CF	4	<i>Carex flacca</i>	Blue Sedge	1 Qt., 12" O.C.
MM	4	<i>Molinia Moorhexe</i>	Purple Moor Grass	1 Qt., 12" O.C.
PH	4	<i>Phlox 'Blue Paradise'</i>	Blue Paradise Phlox	1 Qt., 12" O.C.
RB	8	<i>Rudbeckia 'Little Gold Star'</i>	Blackeyed Susan	1 Qt., 12" O.C.
SF	3	<i>Solidago Fleece 'Golden Fleece'</i>	Goldenrod	1 Qt., 12" O.C.
PERENNIALS				
Ech	51	<i>Echinacea 'Pink Mist'</i>	Coneflower	1 Qt., 12" O.C.
PP	159	<i>Persicaria polymorpha</i>	Knotweed	1 Qt., 12" O.C.

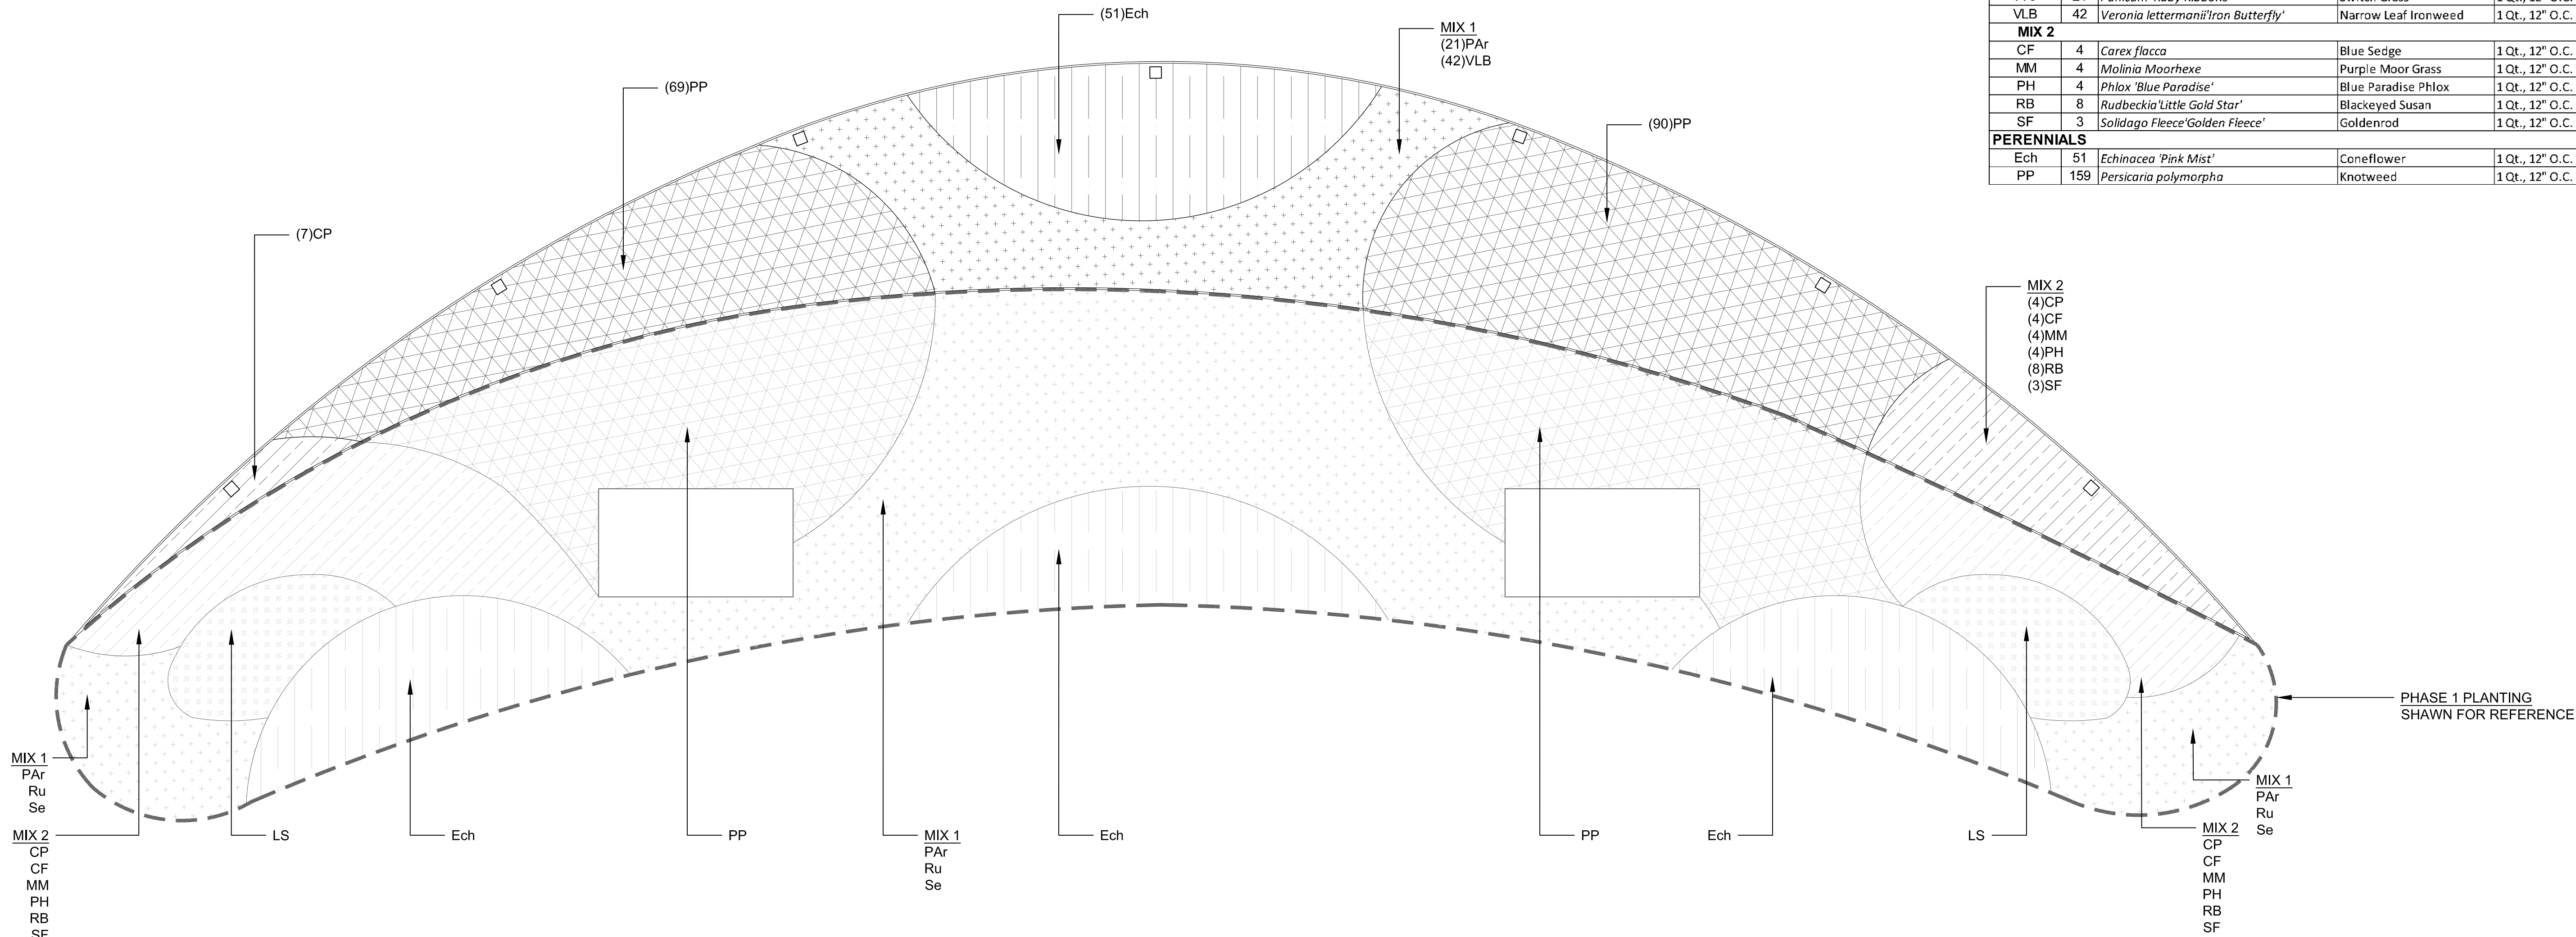


01 BED 3 PLANTING PLAN
1/4"=1'

PLANT SCHEDULE (BED 4A+4B+4C)				
SYM	QTY	BOTANICAL NAME	COMMON NAME	SIZE/SPACING
EVERGREEN SHRUBS				
TCEs	99	<i>Taxus cuspidata</i> 'EMERALD SPREADER'	Emerald Spreader Yew	5 gal., 3' O.C.
PERENNIALS / GRASSES				
CP	510	<i>Carex pensylvanica</i> 55%	Pennsylvania Sedge	1 Qt., 12" O.C.
	140	<i>Carex flacca</i> 15%	Blue green sedge	1 Qt., 12" O.C.
	280	<i>Allium 'Summer Beauty'</i> 30%	Summer Beauty Onion	1 Qt., 12" O.C.
BULBS (DISTRIBUTED THROUGHOUT THE ENTIRE PERENNIAL /GRASSES AREAS)				
ALa	72	<i>Allium atropurpureum</i>	Ornamental Onion	9 bulbs/sf
ALs	72	<i>Allium sphaerocephalon</i>	Round headed Leek	7 bulbs/sf
CR1	72	<i>Crocus sp.</i>	Bieberstein's Crocus	9 bulbs/sf
GAi	72	<i>Galanthus ikariae</i>	Snowdrop	9 bulbs/sf
HYc	72	<i>Hyacinth 'Carnegie'</i>	Hyacinth Orientalis	9 bulbs/sf
NAi	72	<i>Narcissus 'Ice Follies'</i>	Large-Cupped Daffodil	7 bulbs/sf
NAj	72	<i>Narcissus Jet Fire</i>	Cyclamineus Daffodil	7 bulbs/sf
NAi	72	<i>Narcissus thalia</i>	Triandrus Daffodil	7 bulbs/sf
TUm	72	<i>Tulipa 'Menton'</i>	Menton Tulip	7 bulbs/sf
TUp	72	<i>Tulipa 'Pittsburgh'</i>	Triumph Tulip	7 bulbs/sf

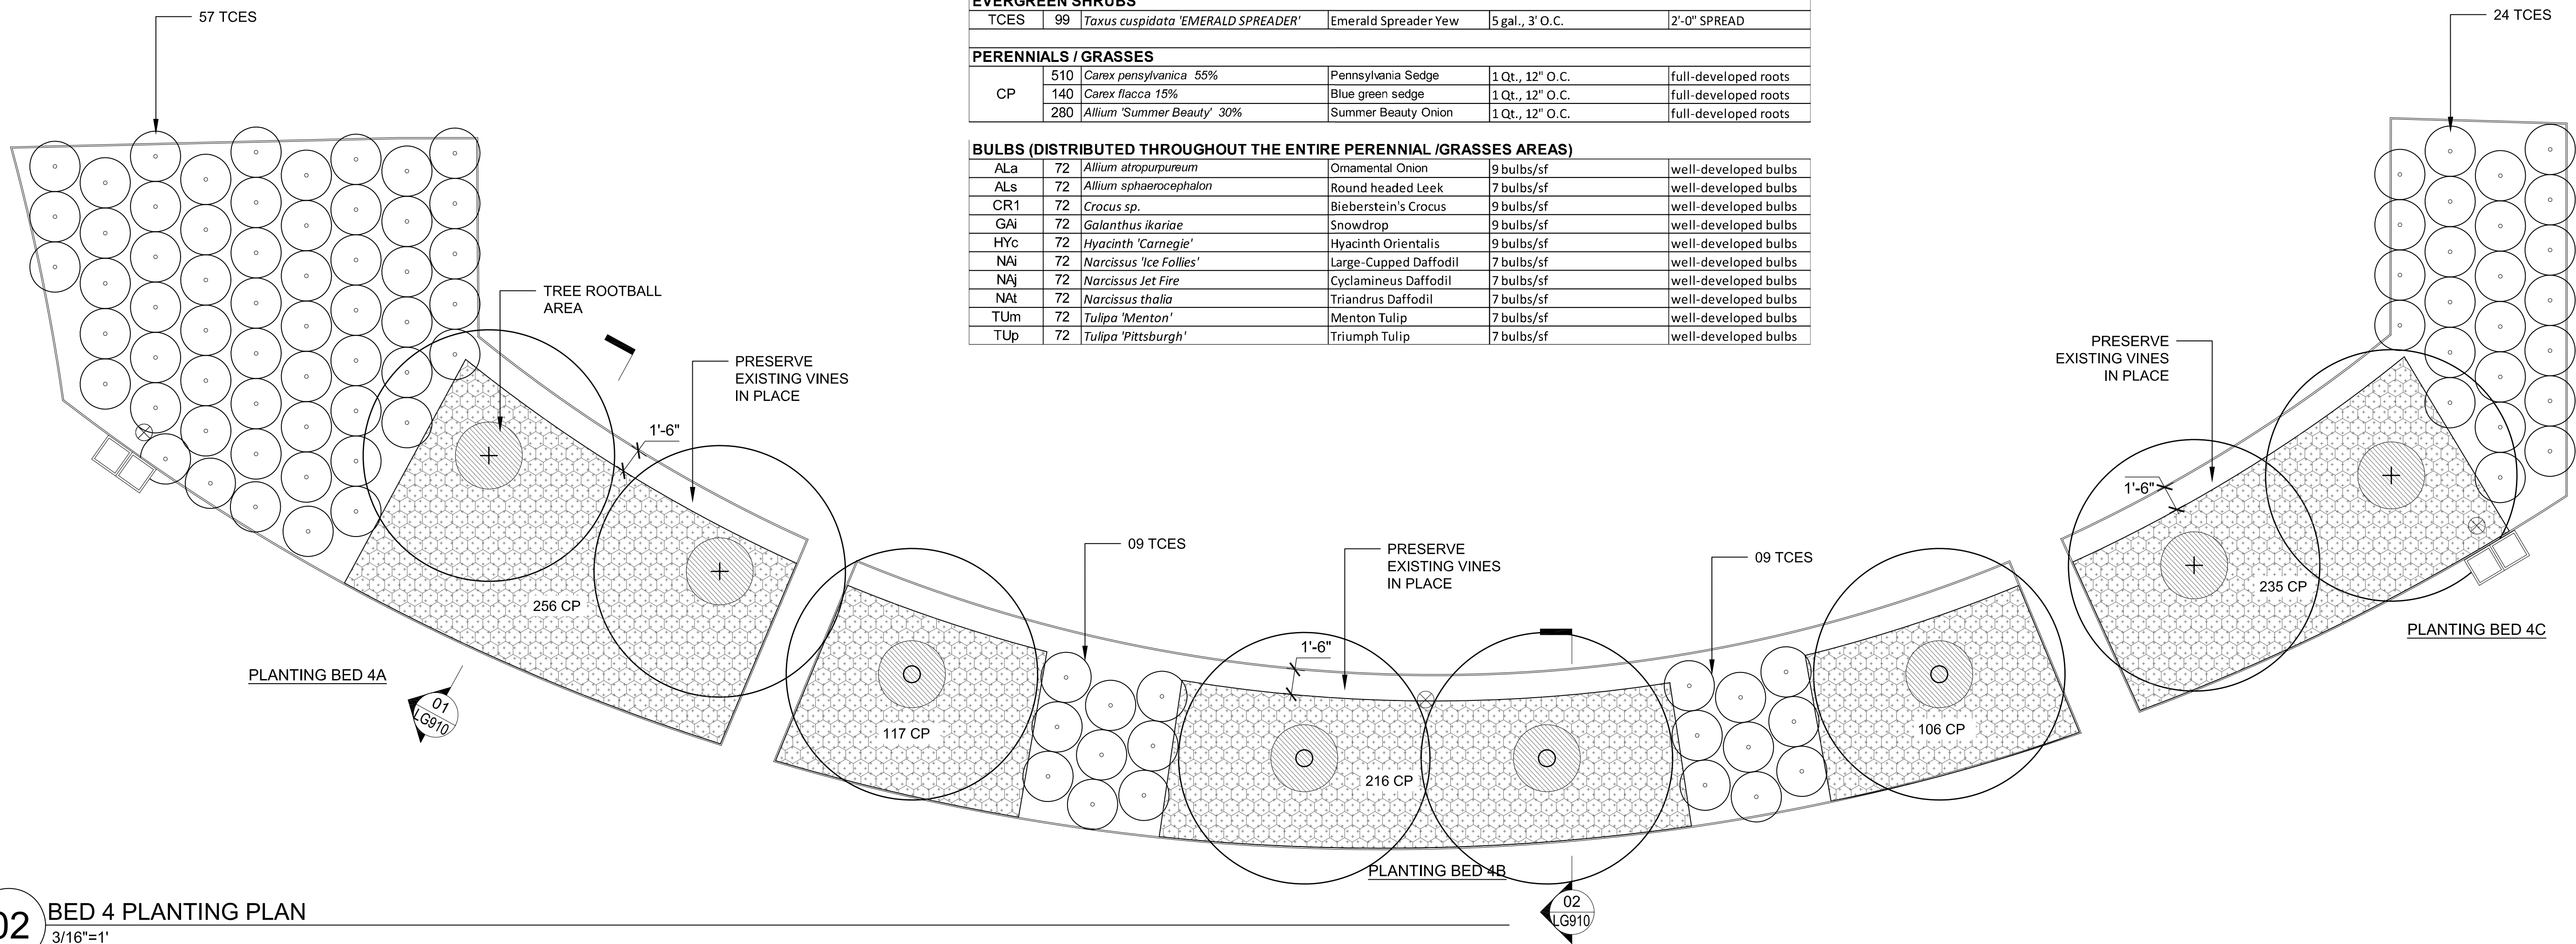

02 BED 4 PLANTING PLAN
3/16"=1'

KEY PLAN :

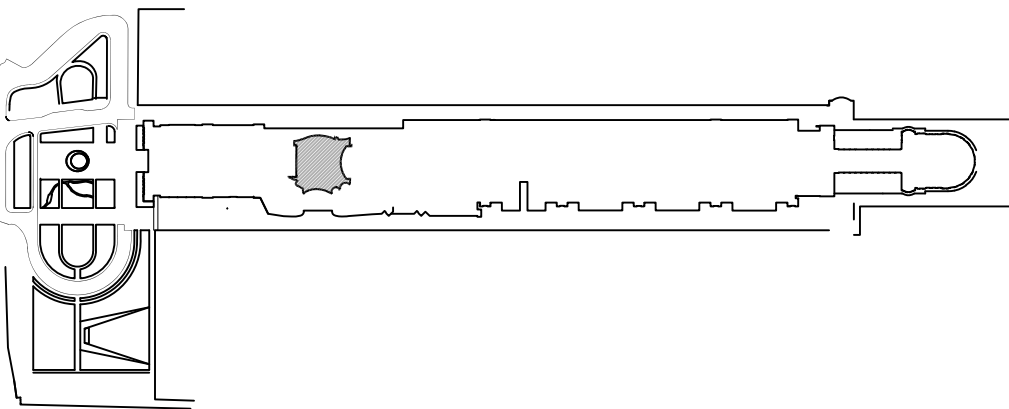

LEGEND :

STAMP :



REVISION :

NO.	DATE	DESCRIPTION	BY

LANDSCAPE ARCHITECT :

James Corner Field Operations
475 Tenth Ave, 9F New York, NY 10018

CONSULTANT TEAM :

Gensler 11 E Madison St #300, Chicago, IL 60602	Pentagram 204 Fifth Avenue, New York NY 10010
nArchitects 69 Jay Street, #317, Brooklyn, NY 11201	Jeffrey L. Bruce & Company, LLC 1907 South Street, Suite 204, North Kansas City, Missouri 64118
Thornton Tomasetti 330 N. Wabash Avenue, Suite 1500, Chicago, IL 60611	Environmental Systems Design 175 West Jackson Boulevard, Suite 1600, Chicago, Illinois 60604
Milhouse 65 E. Van Buren St., STE 1501, Chicago, IL 60605	Terry Guen Design Associates 714 South Dearborn Street, #5, Chicago, Illinois 60605
L'Observatoire International 120 Walker Street 7 Floor East, New York, New York 10013	

CLIENT :

Navy Pier, Inc.
600 East Grand Avenue, Chicago, IL 60611

PROJECT NAME

CHICAGO NAVY PIER, PHASE 2

DESCRIPTION **100% CONSTRUCTION DOCUMENTS**

DRAWN **BS** CHECKED **SWA**


DATE **08.21.2015** SCALE **AS NOTED**

DRAWING TITLE
PLANTING DETAIL PLAN 02


DRAWING NO.

L-M-402

All Rights Reserved
These drawing, concepts, designs and Ideas are the property of James Corner Field Operations. They may not be copied, reproduced, disclosed to others or used in connection with any work other than the specified project for which they were prepared, in whole or in part, without the prior written authorization of James Corner Field Operations.

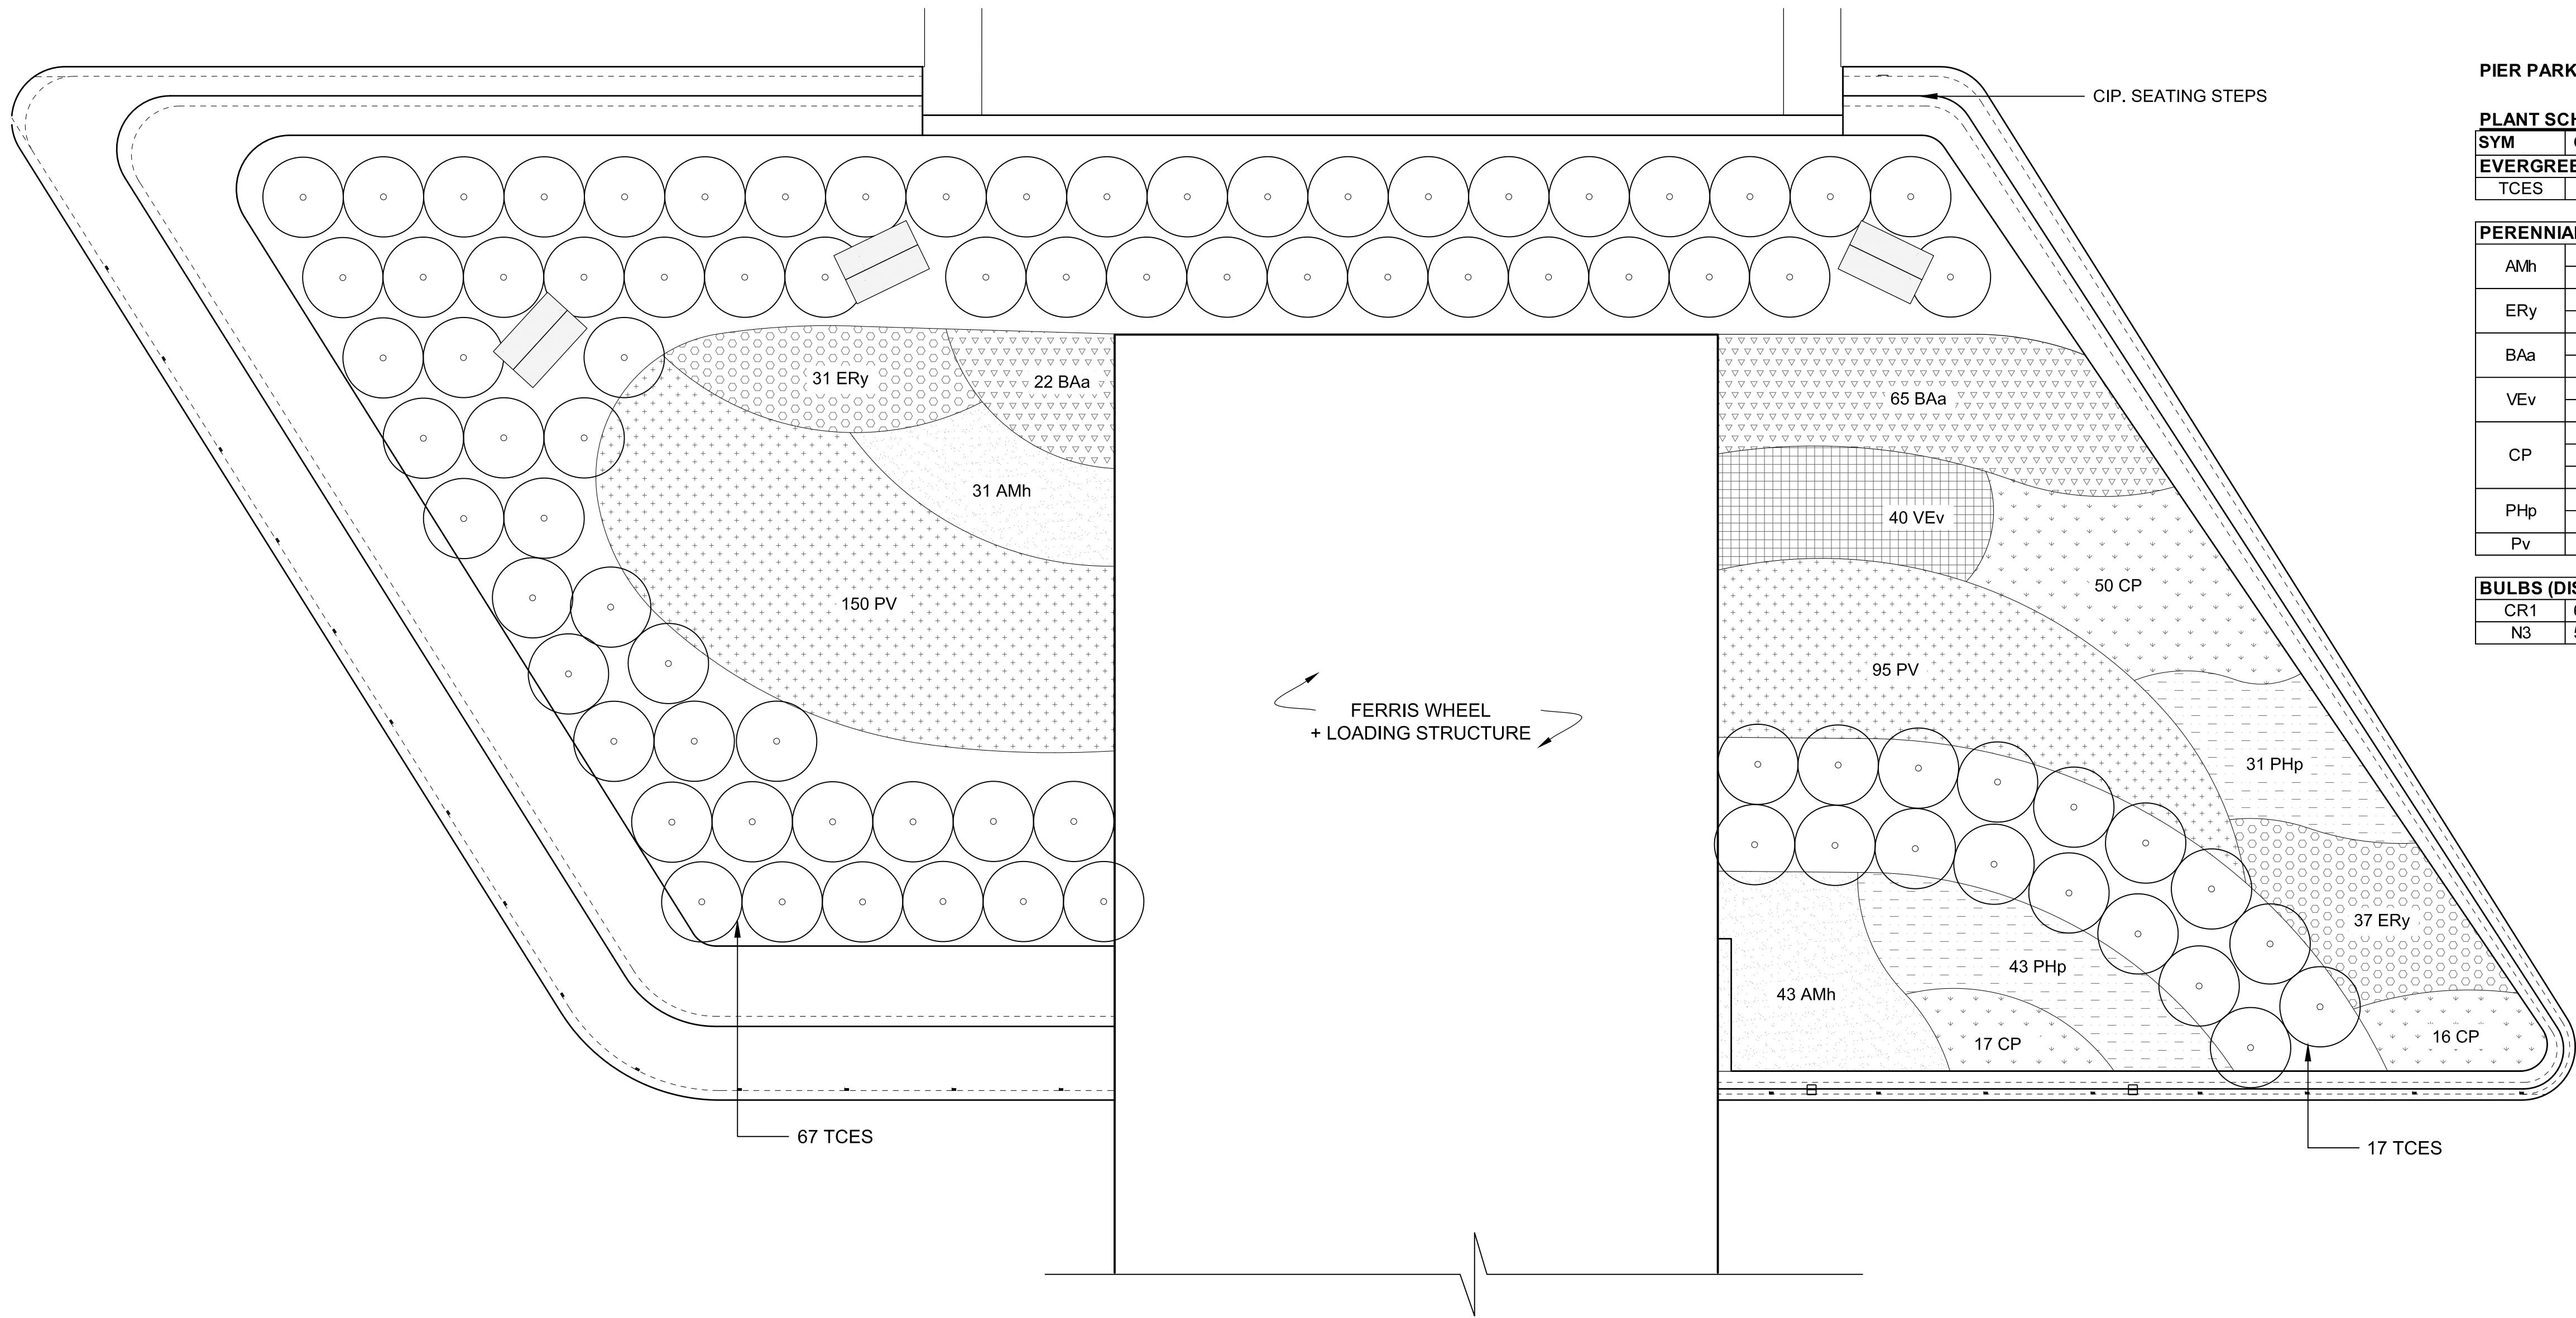

01 BED 1 PLANTING PLAN
1/4"=1'

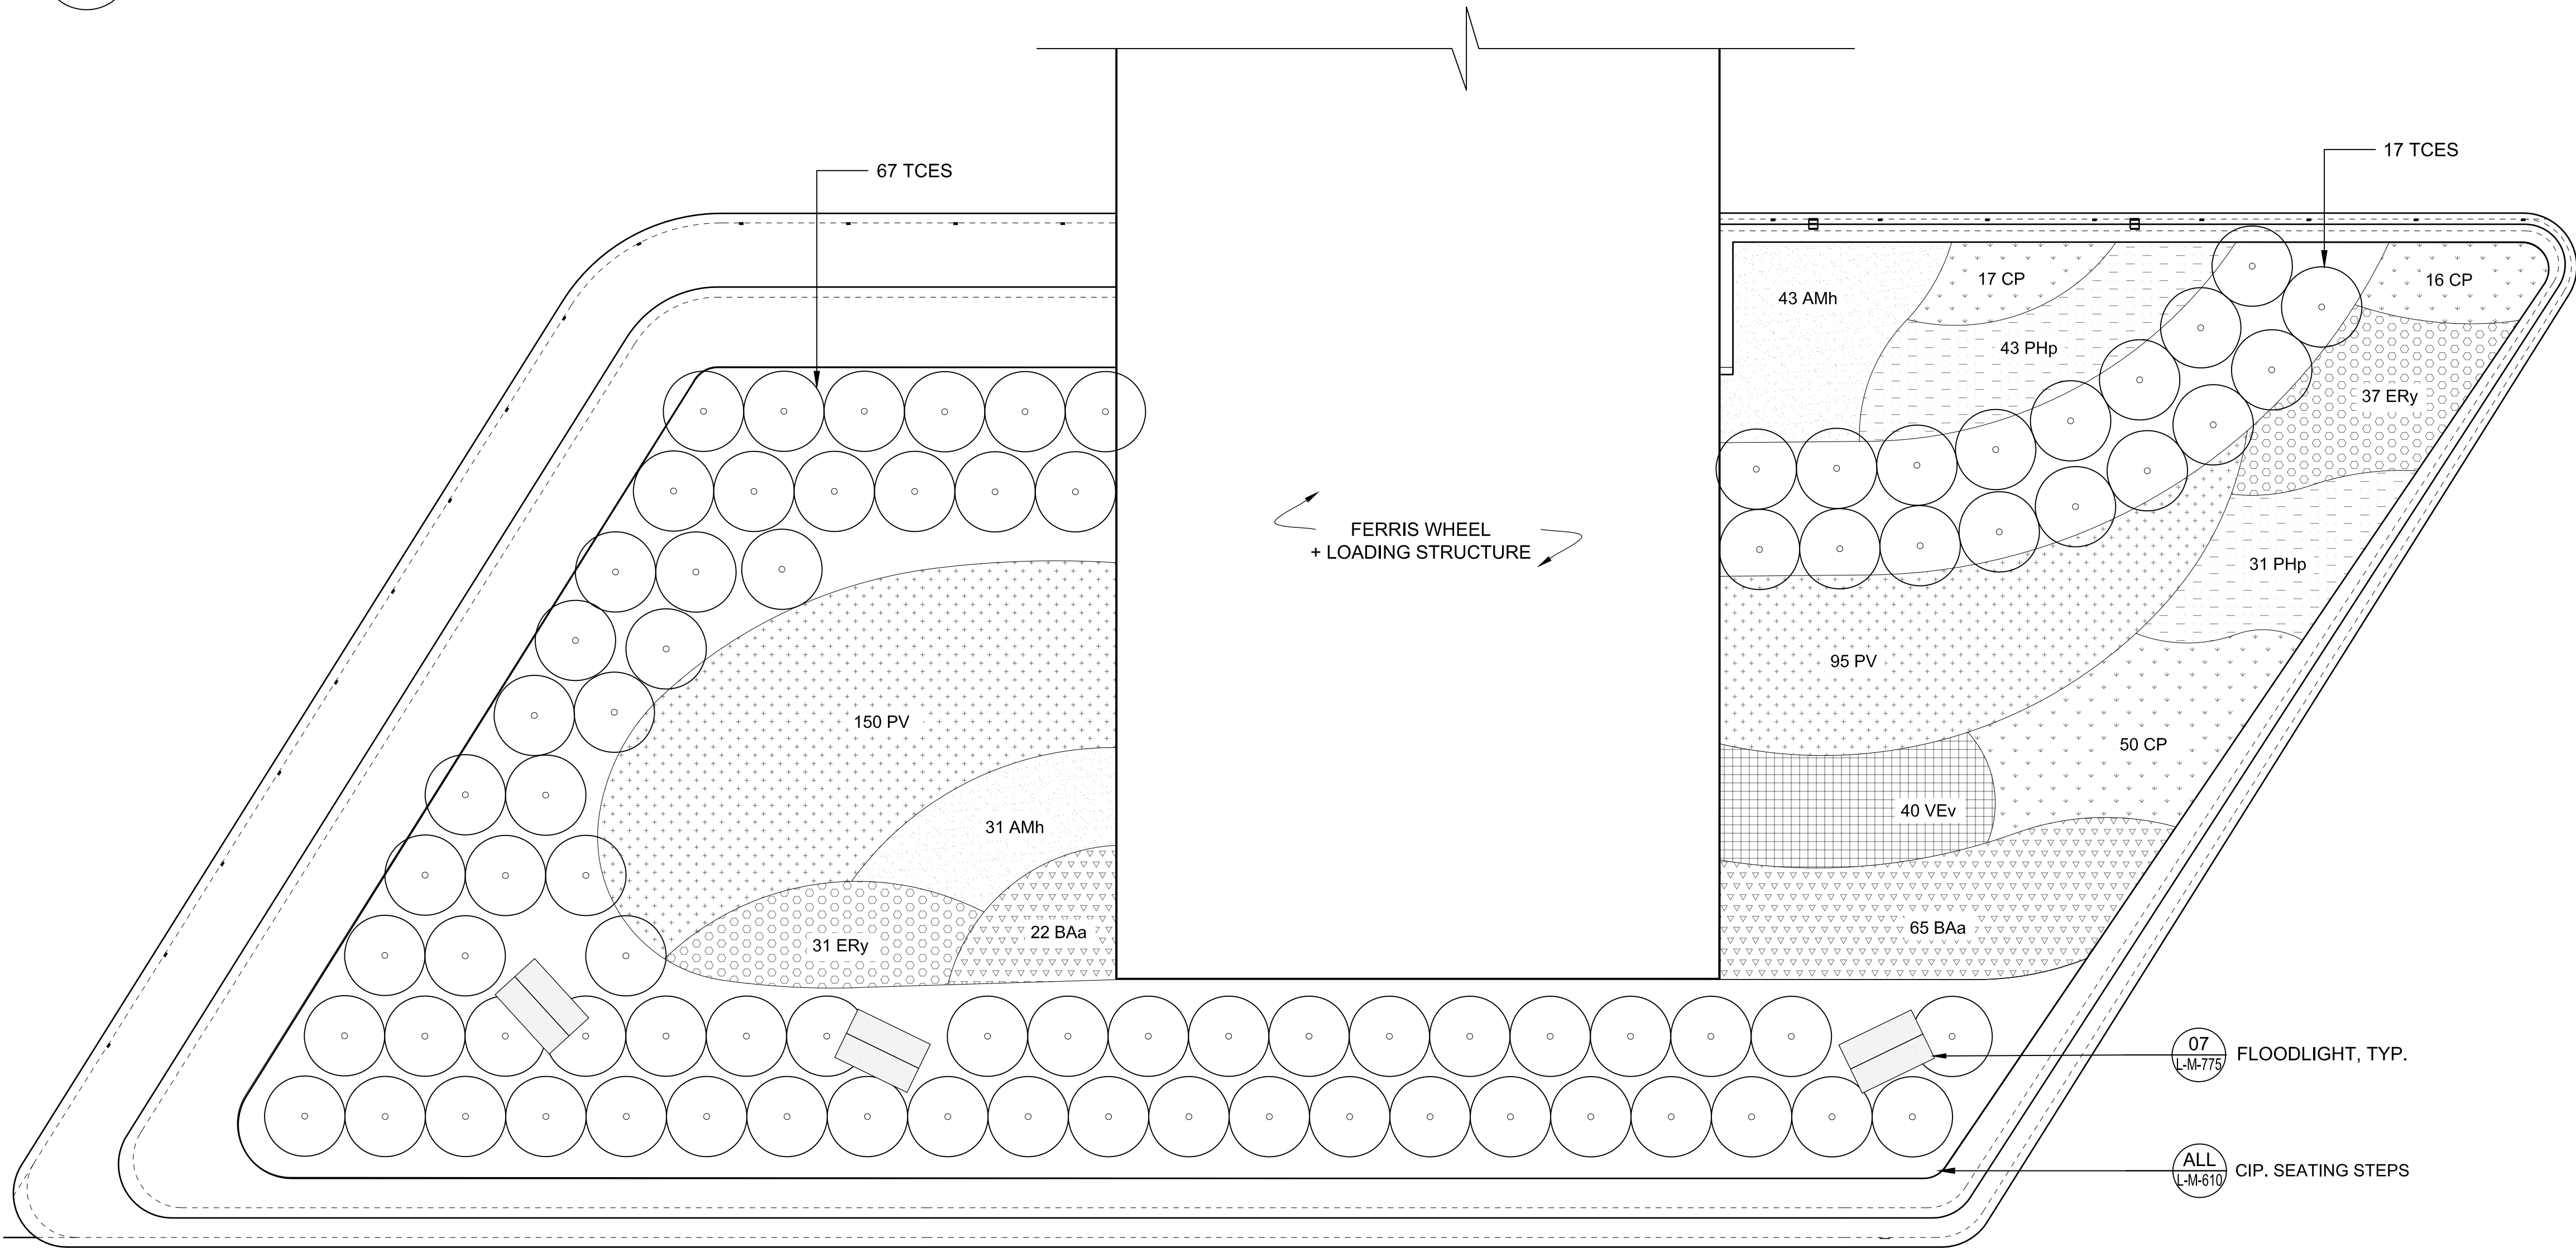


02 BED 2 PLANTING PLAN
1/4"=1'

PIER PARK BED 1+BED 2 PLANTING SCHEDULE

PLANT SCHEDULE (BED 1+BED 2)					
SYM	QTY	BOTANICAL NAME	COMMON NAME	SIZE/SPACING	NOTES
EVERGREEN SHRUBS					
TCES	168	<i>Taxus cuspidata</i> 'EMERALD SPREADER'	Emerald Spreader Yew	5 gal., 3' O.C.	3'-0" SPREAD
PERENNIALS / GRASSES					
AMh	74	<i>Amonia hubrichtii</i> 50%	Blue Star	1 Qt., 12" O.C.	full-developed roots
	74	<i>Geranium 'Gerwat'</i> 50%	Cranesbill	1 Qt., 12" O.C.	full-developed roots
	68	<i>Eryngium yuccifolium</i> 50%	Rattlesnake Master	1 Qt., 12" O.C.	full-developed roots
ERY	68	<i>Liatris spicata 'kobold'</i> 50%	Blazing Star	1 Qt., 12" O.C.	full-developed roots
	104	<i>Baptisia alba</i> 60%	False Indigo	1 Qt., 12" O.C.	full-developed roots
	70	<i>Lespedeza capitata</i> 40%	Round headed bush clover	1 Qt., 12" O.C.	full-developed roots
VEV	48	<i>Veronicastrum virginicum</i> 60%	Culver's Root	1 Qt., 12" O.C.	full-developed roots
	32	<i>Silphium terebinthinaceum</i> 40%	Prairie Dock	1 Qt., 12" O.C.	full-developed roots
	90	<i>Carex pensylvanica</i> 55%	Pennsylvania Sedge	1 Qt., 12" O.C.	full-developed roots
CP	26	<i>Carex flacca</i> 15%	Blue green sedge	1 Qt., 12" O.C.	full-developed roots
	50	<i>Allium 'Summer Beauty'</i> 30%	Summer Beauty Onion	1 Qt., 12" O.C.	full-developed roots
	60	<i>Phlox 'Minnie Pearl'</i> 40%	Phlox Hybrid	1 Qt., 12" O.C.	full-developed roots
PHp	88	<i>Solidago sphacelata 'Golden Fleece'</i> 60%	Goldenrod	1 Qt., 12" O.C.	full-developed roots
	Pv	490	<i>Panicum virgatum 'Northwind'</i>	Switchgrass	1 Qt., 12" O.C.
BULBS (DISTRIBUTED THROUGHOUT THE ENTIRE PERENNIAL /GRASSES AREAS)					
CR1	6760	<i>Crocus sp.</i>	Bieberstein's Crocus	9 bulbs/sf	well-developed bulbs
N3	5260	<i>Narcissus Jet Fire</i>	Cyclamineus Daffodil	7 bulbs/sf	well-developed bulbs

KEY PLAN :

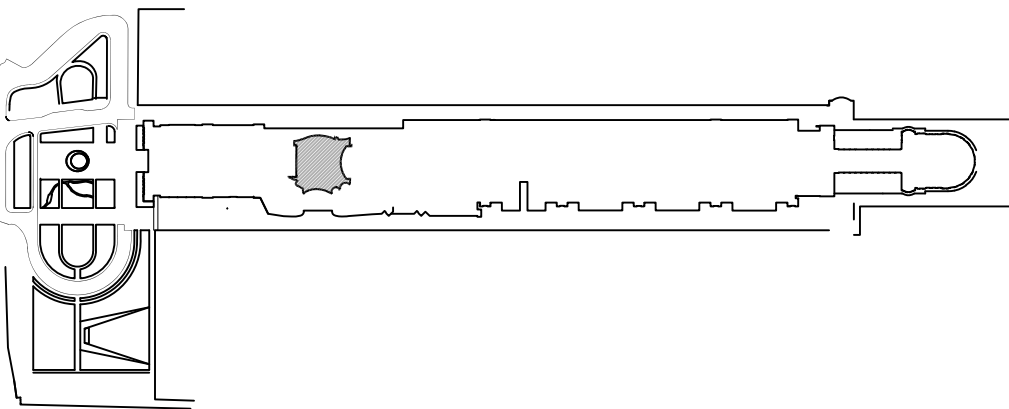

LEGEND :

STAMP :



REVISION :

NO.	DATE	DESCRIPTION	BY

LANDSCAPE ARCHITECT :
James Corner Field Operations
475 Tenth Ave, 9F New York, NY 10018

CONSULTANT TEAM :
Gensler
11 E Madison St #300, Chicago, IL 60602
nArchitects
68 Jay Street #317, Brooklyn, NY 11201
Thornton Tomasetti
330 N. Wabash Avenue, Suite 1500, Chicago, IL 60611
Millhouse
65 E. Van Buren St., STE 1501, Chicago, IL 60605
L'Observatoire International
120 Walker Street 7 Floor East, New York, New York 10013

Pentagram
204 Fifth Avenue, New York NY 10010
Jeffrey L. Bruce & Company, LLC
1907 Swift Street, Suite 204, North Kansas City, Missouri 64116
Environmental Systems Design
175 West Jackson Boulevard, Suite 1600, Chicago, Illinois 60604
Terry Guen Design Associates
714 South Dearborn Street #5, Chicago, Illinois 60605

CLIENT :
Navy Pier, Inc.
600 East Grand Avenue, Chicago, IL 60611

PROJECT NAME
CHICAGO NAVY PIER, PHASE 2

DESCRIPTION **100% CONSTRUCTION DOCUMENTS**

DRAWN **BS** CHECKED **SWA**


DATE **08.21.2015** SCALE **AS NOTED**


DRAWING TITLE
PLANTING DETAIL PLAN 01

DRAWING NO.
L-M-401

All Rights Reserved
These drawing, concepts, designs and Ideas are the property of James Corner Field Operations. They may not be copied, reproduced, disclosed to others or used in connection with any work other than the specified project for which they were prepared, in whole or in part, without the prior written authorization of James Corner Field Operations.

5' 0' 5' 10'

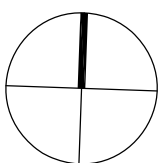

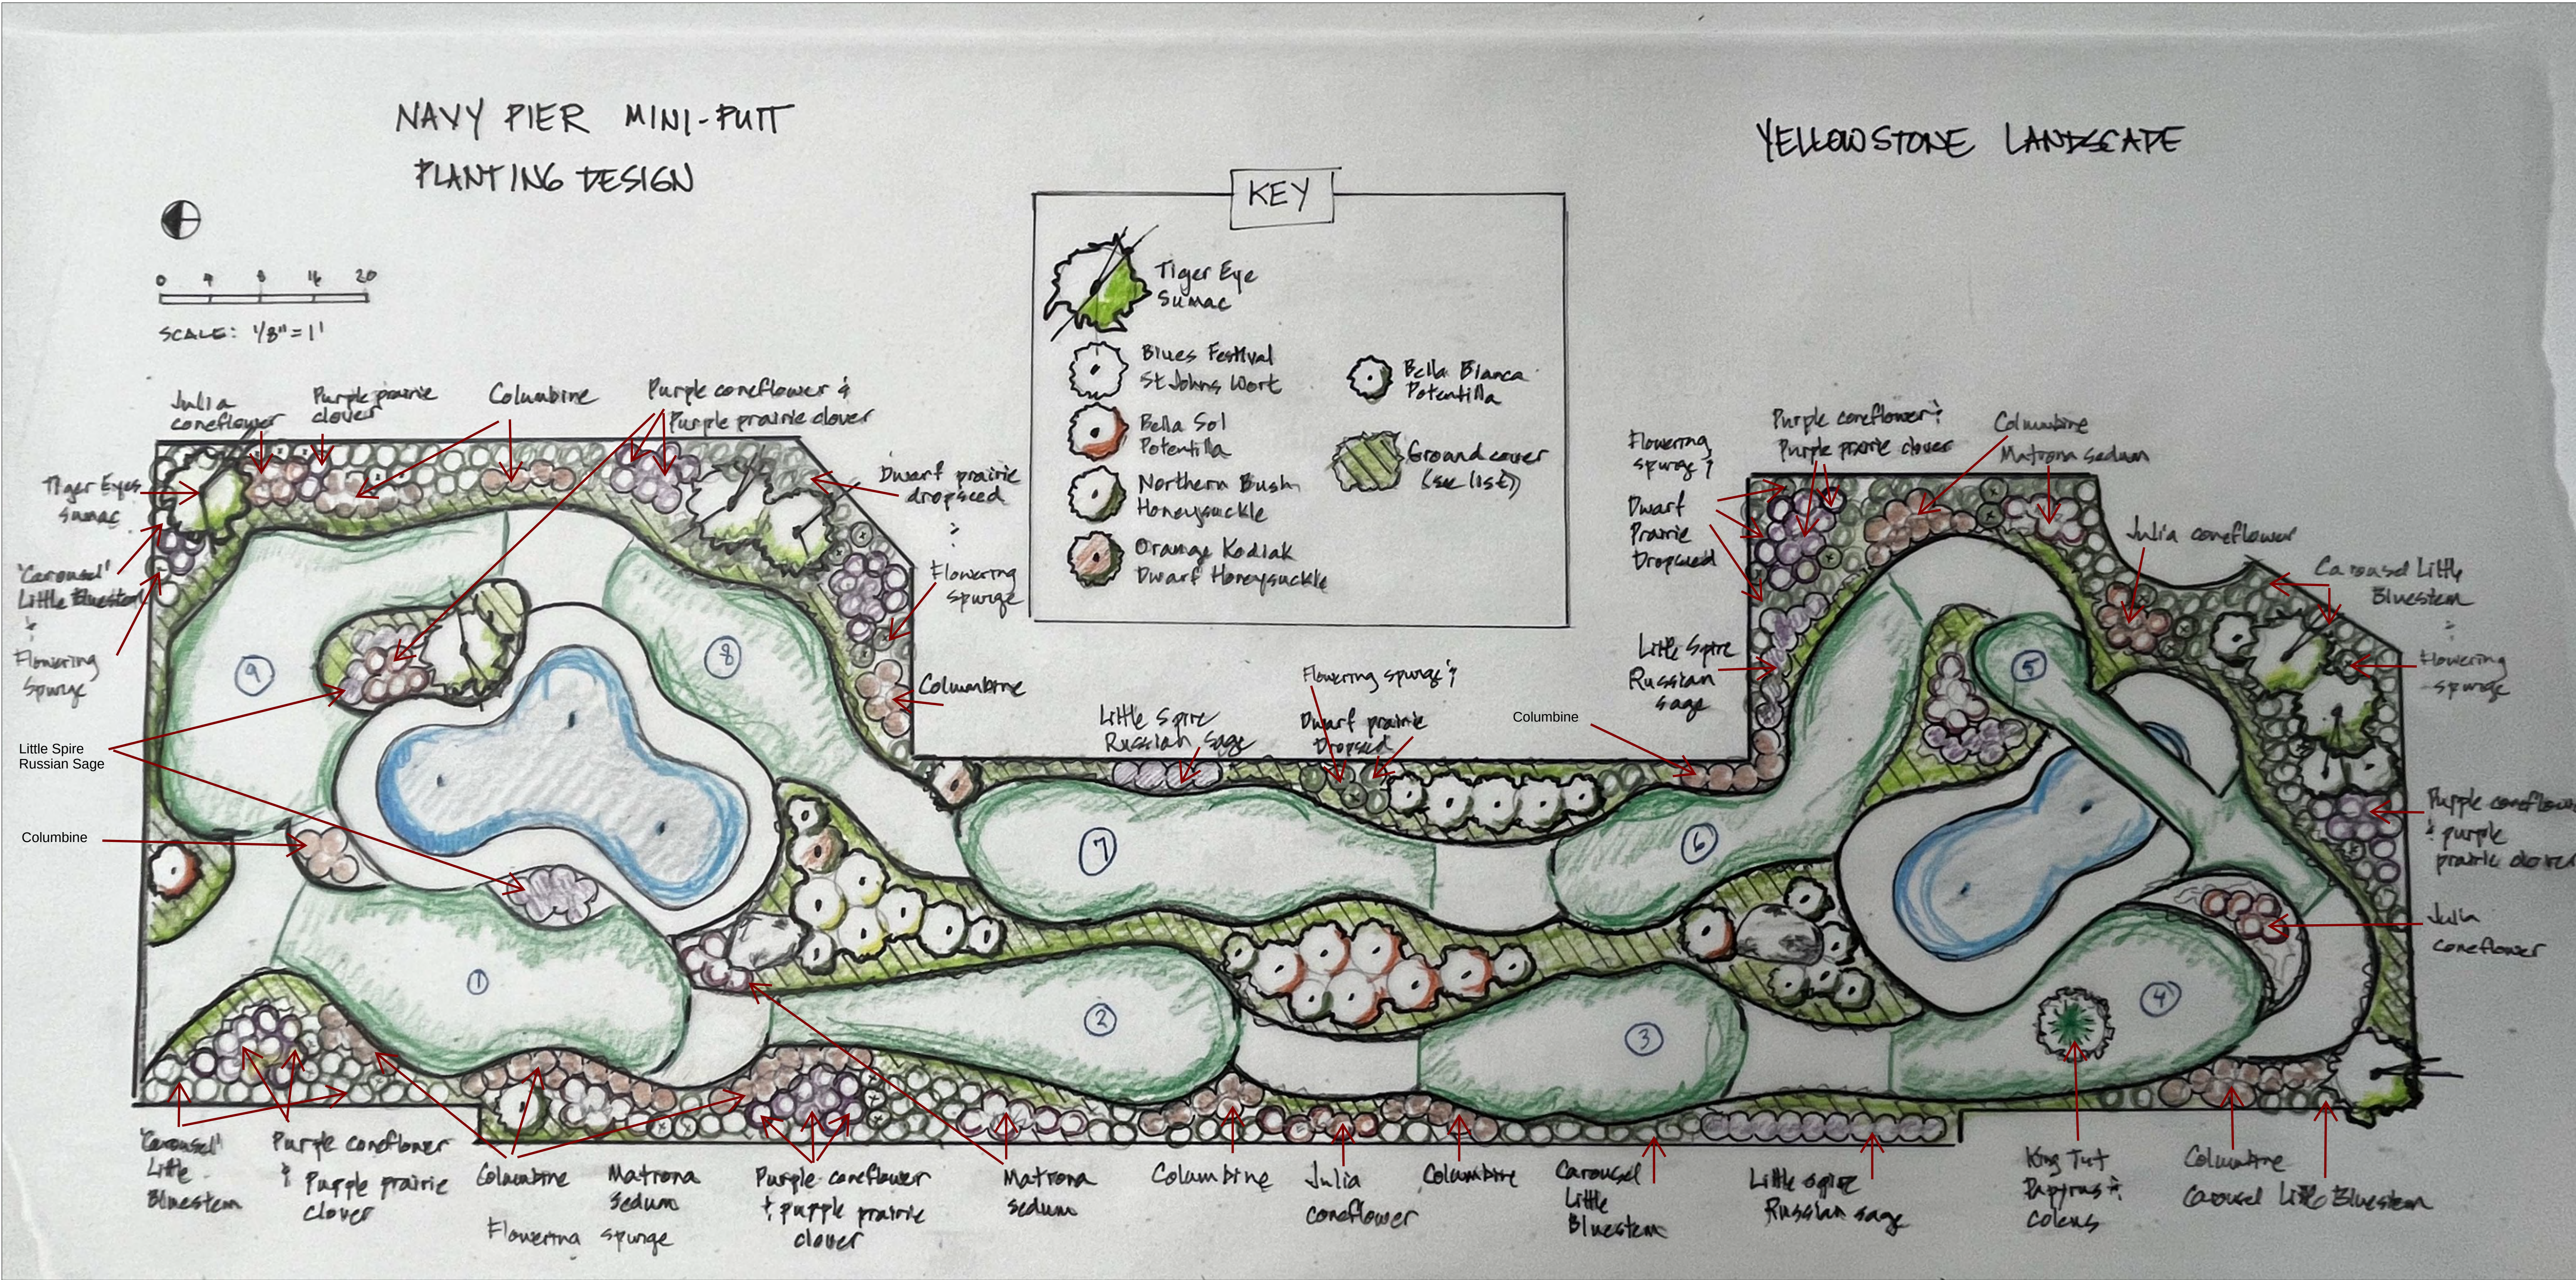



LANDSCAPE PLAN

Mini-Golf Planting

Navy Pier

Yellowstone Landscape
2901 W. 31st Street Chicago 60623
T - 773-807-0304
abowman@yellowstonelandscape.com

REVISION:
DATE: 4-15-2024
DRAWN BY: A Bowman
SCALE: AS SHOWN
SHEET L-1
1 OF 1 SHEETS
JOB NO. -----

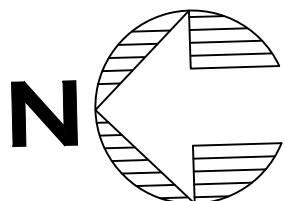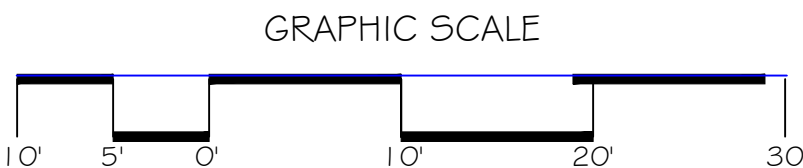

YELLOWSTONE LANDSCAPE, LLC. COPYRIGHTED MATERIALS 2016